


BUILDING ELEVATION
SCALE: 1/8"=1'-0"

BUILDING ELEVATION
SCALE: 1/8"=1'-0"

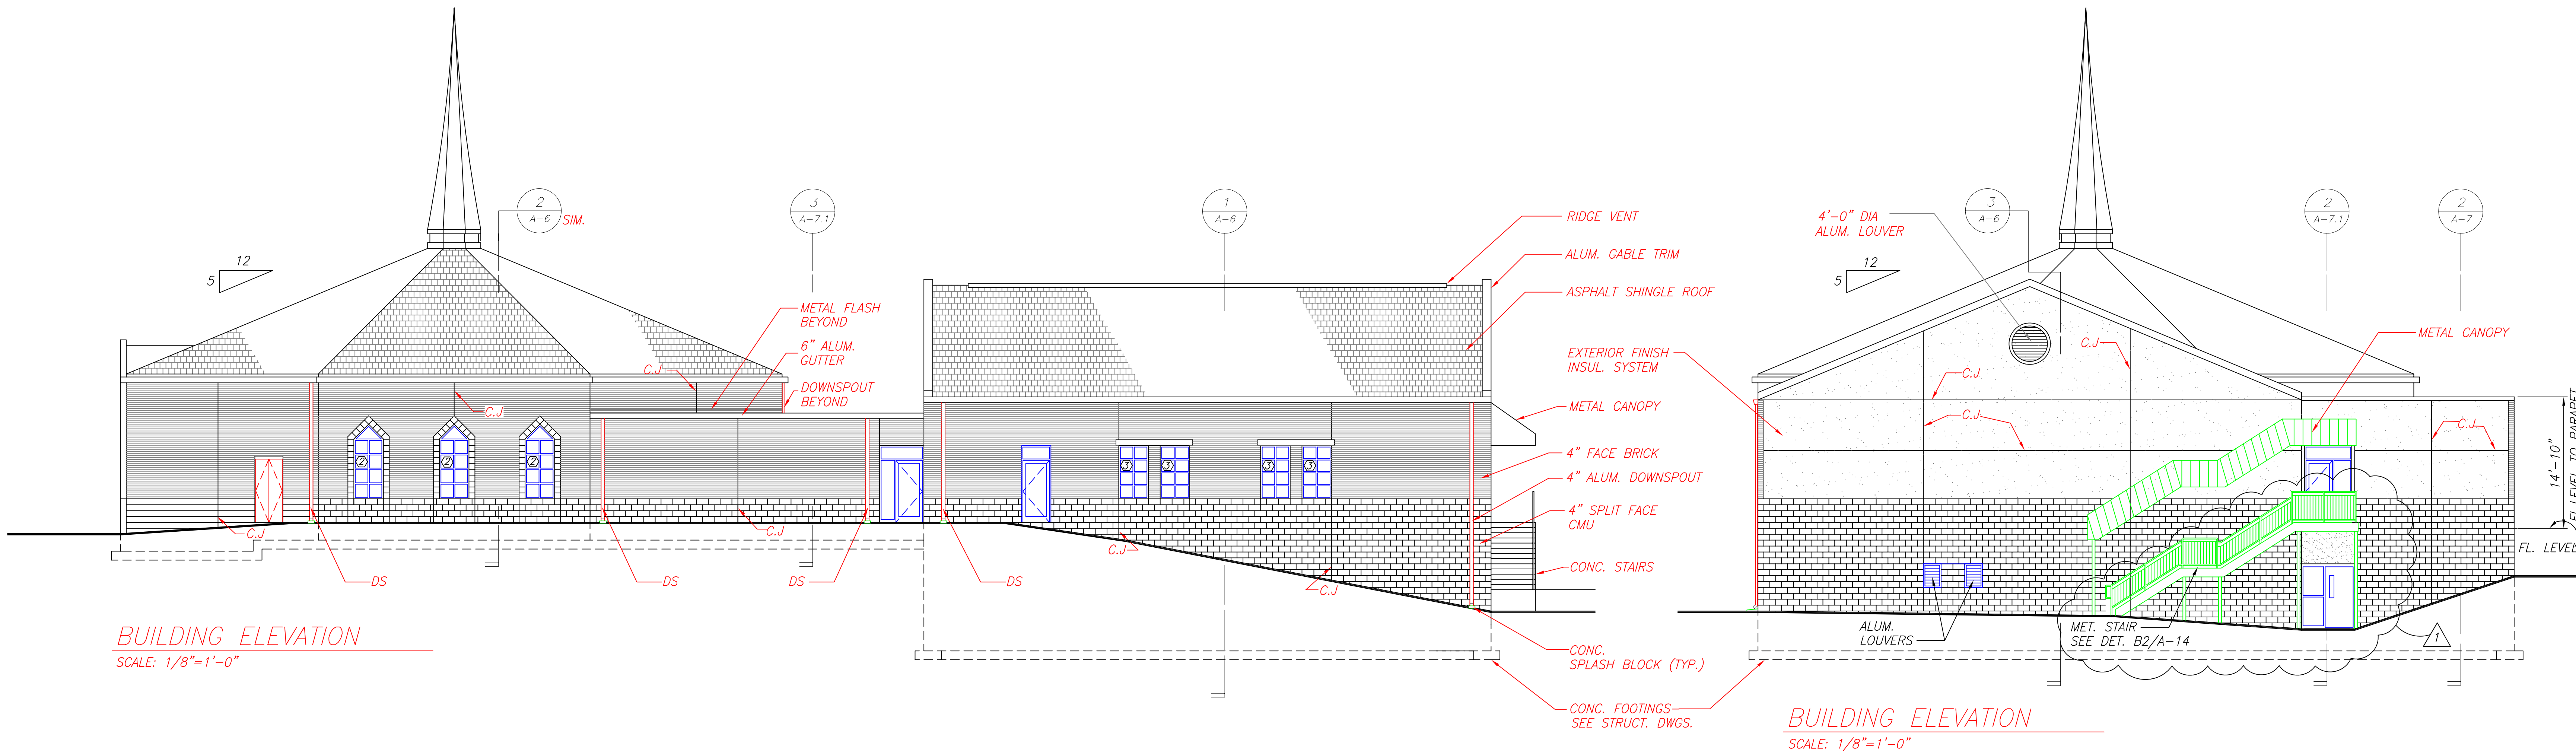

BUILDING ELEVATION
SCALE: 1/8"=1'-0"

BUILDING ELEVATION
SCALE: 1/8"=1'-0"


Date: 1-14-08

Revisions:	COUNTY REVIEW COMMENTS

Consultants: WARDER & ASSOCIATES INC.
CHURCH EXPANSION SPECIALISTS
8016 Old Alexandria Ferry Road
Clinton, Maryland 20735
Phone: 301-868-5800

Certification:

Project Title: BETH SHALOM A.M.E. ZION CHURCH
2501 RITCHIE ROAD
DISTRICT HEIGHTS, MARYLAND 20735
BUILDING ELEVATIONS

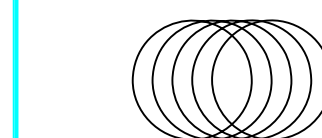

Philip Aaron Lacy, Architects
6188 Oxon Hill Road, Suite 303
Oxon Hill, Maryland 20745
Phone: 301-567-8223

Date: DEC. 1, 2005
Scale: 1/8"=1'-0"
Drawn: PAL
Checked: PAL
File No. BETH_A04

Drawing No.

A-4

of