




Copyright 2004 Philip Aaron Lacy, Architect. All rights reserved. No portion of this document may be reproduced without written permission.

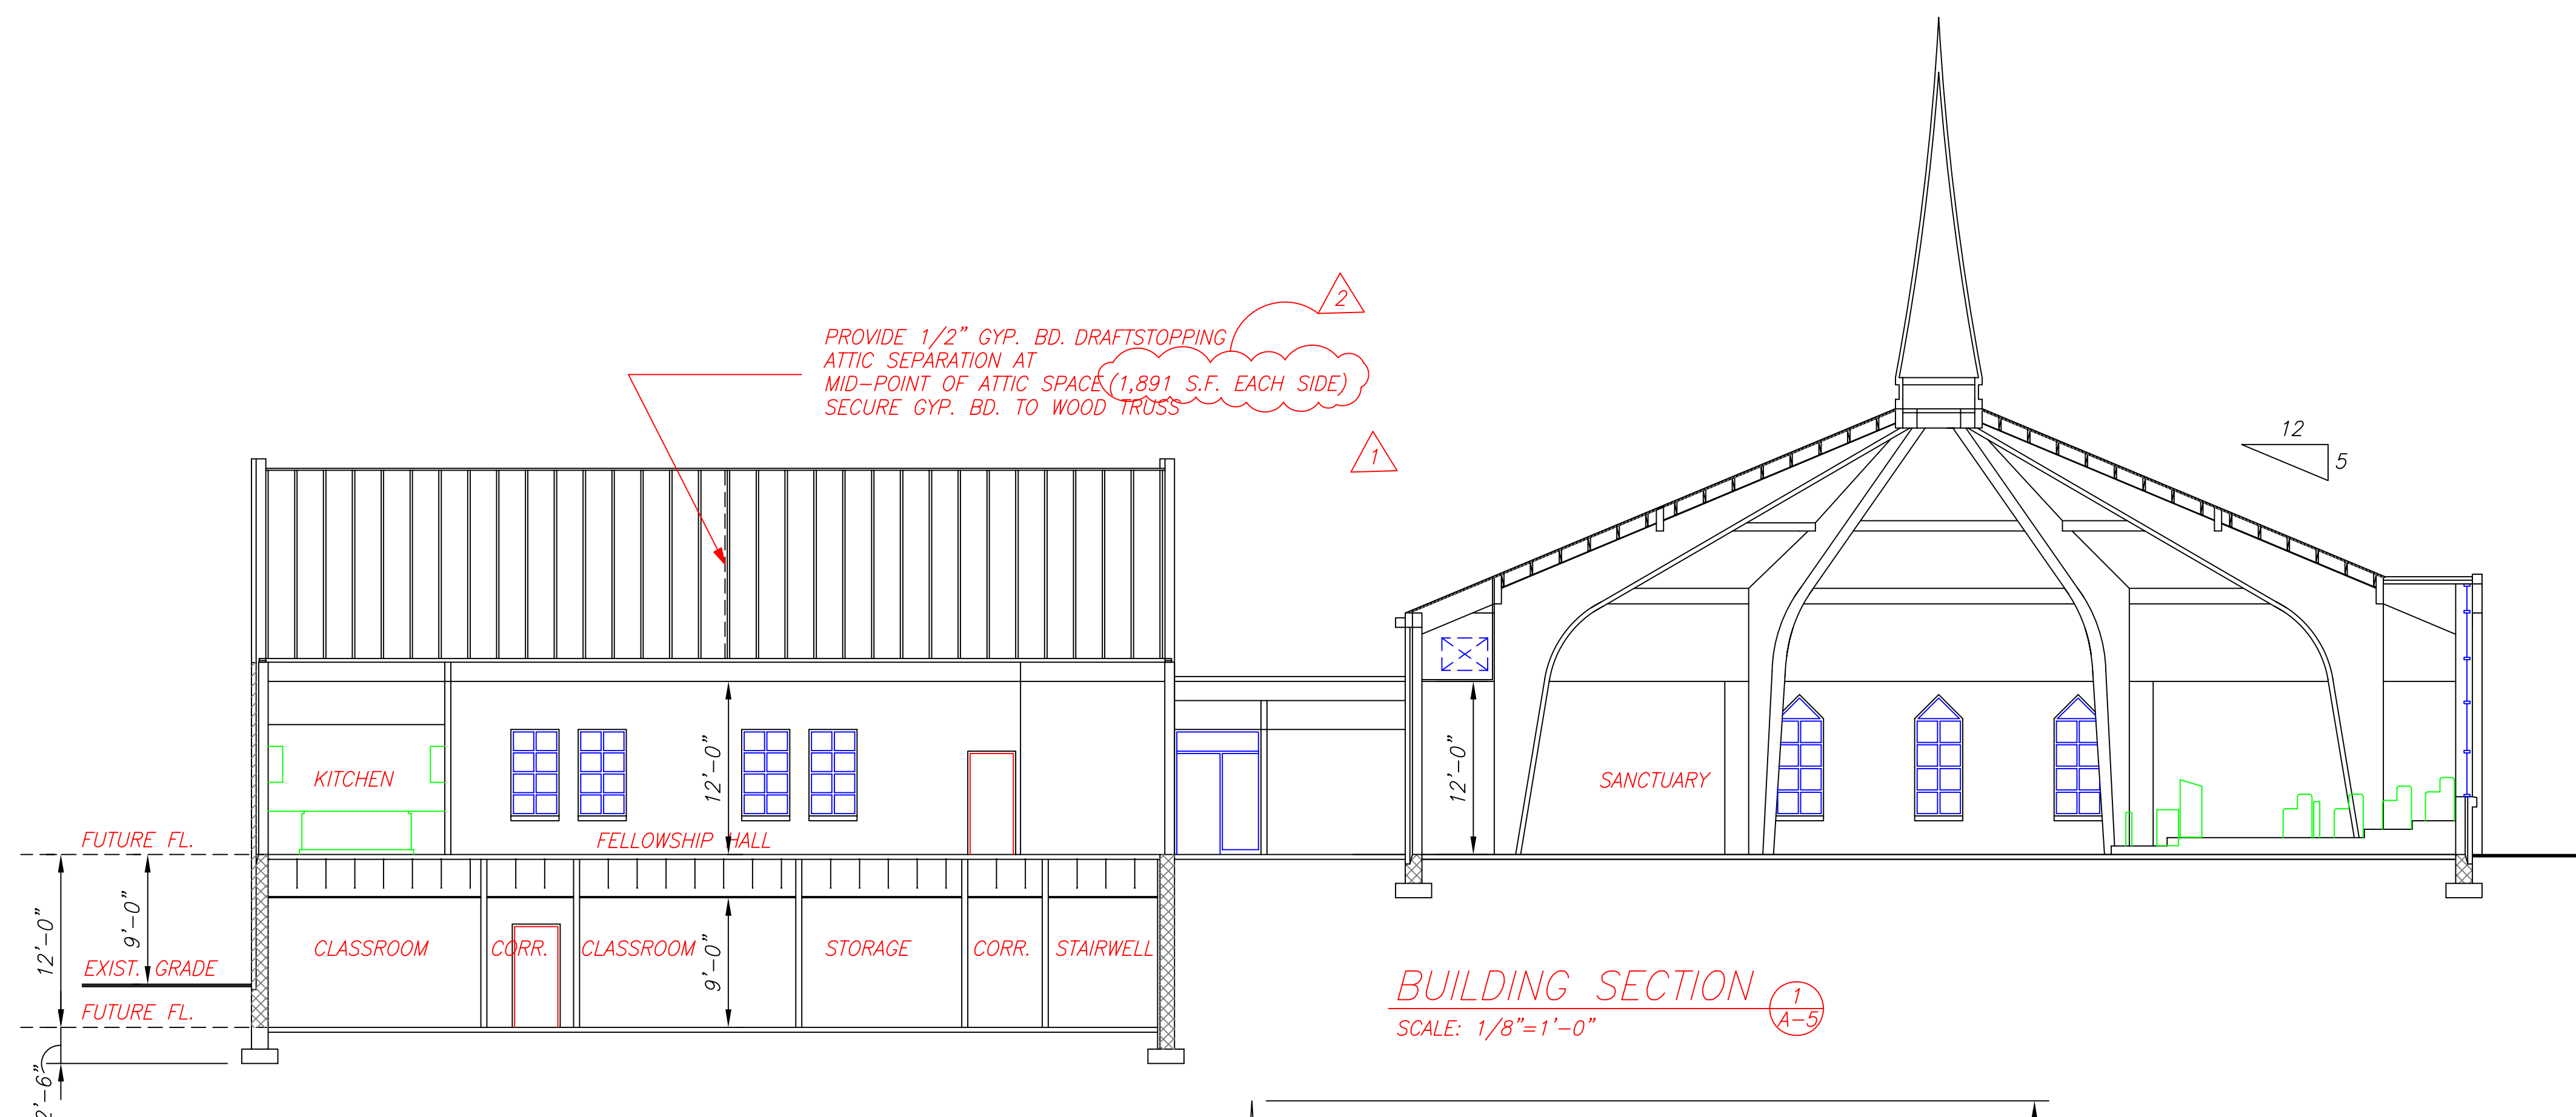


BUILDING SECTION 1
SCALE: 1/8"=1'-0"
A-5

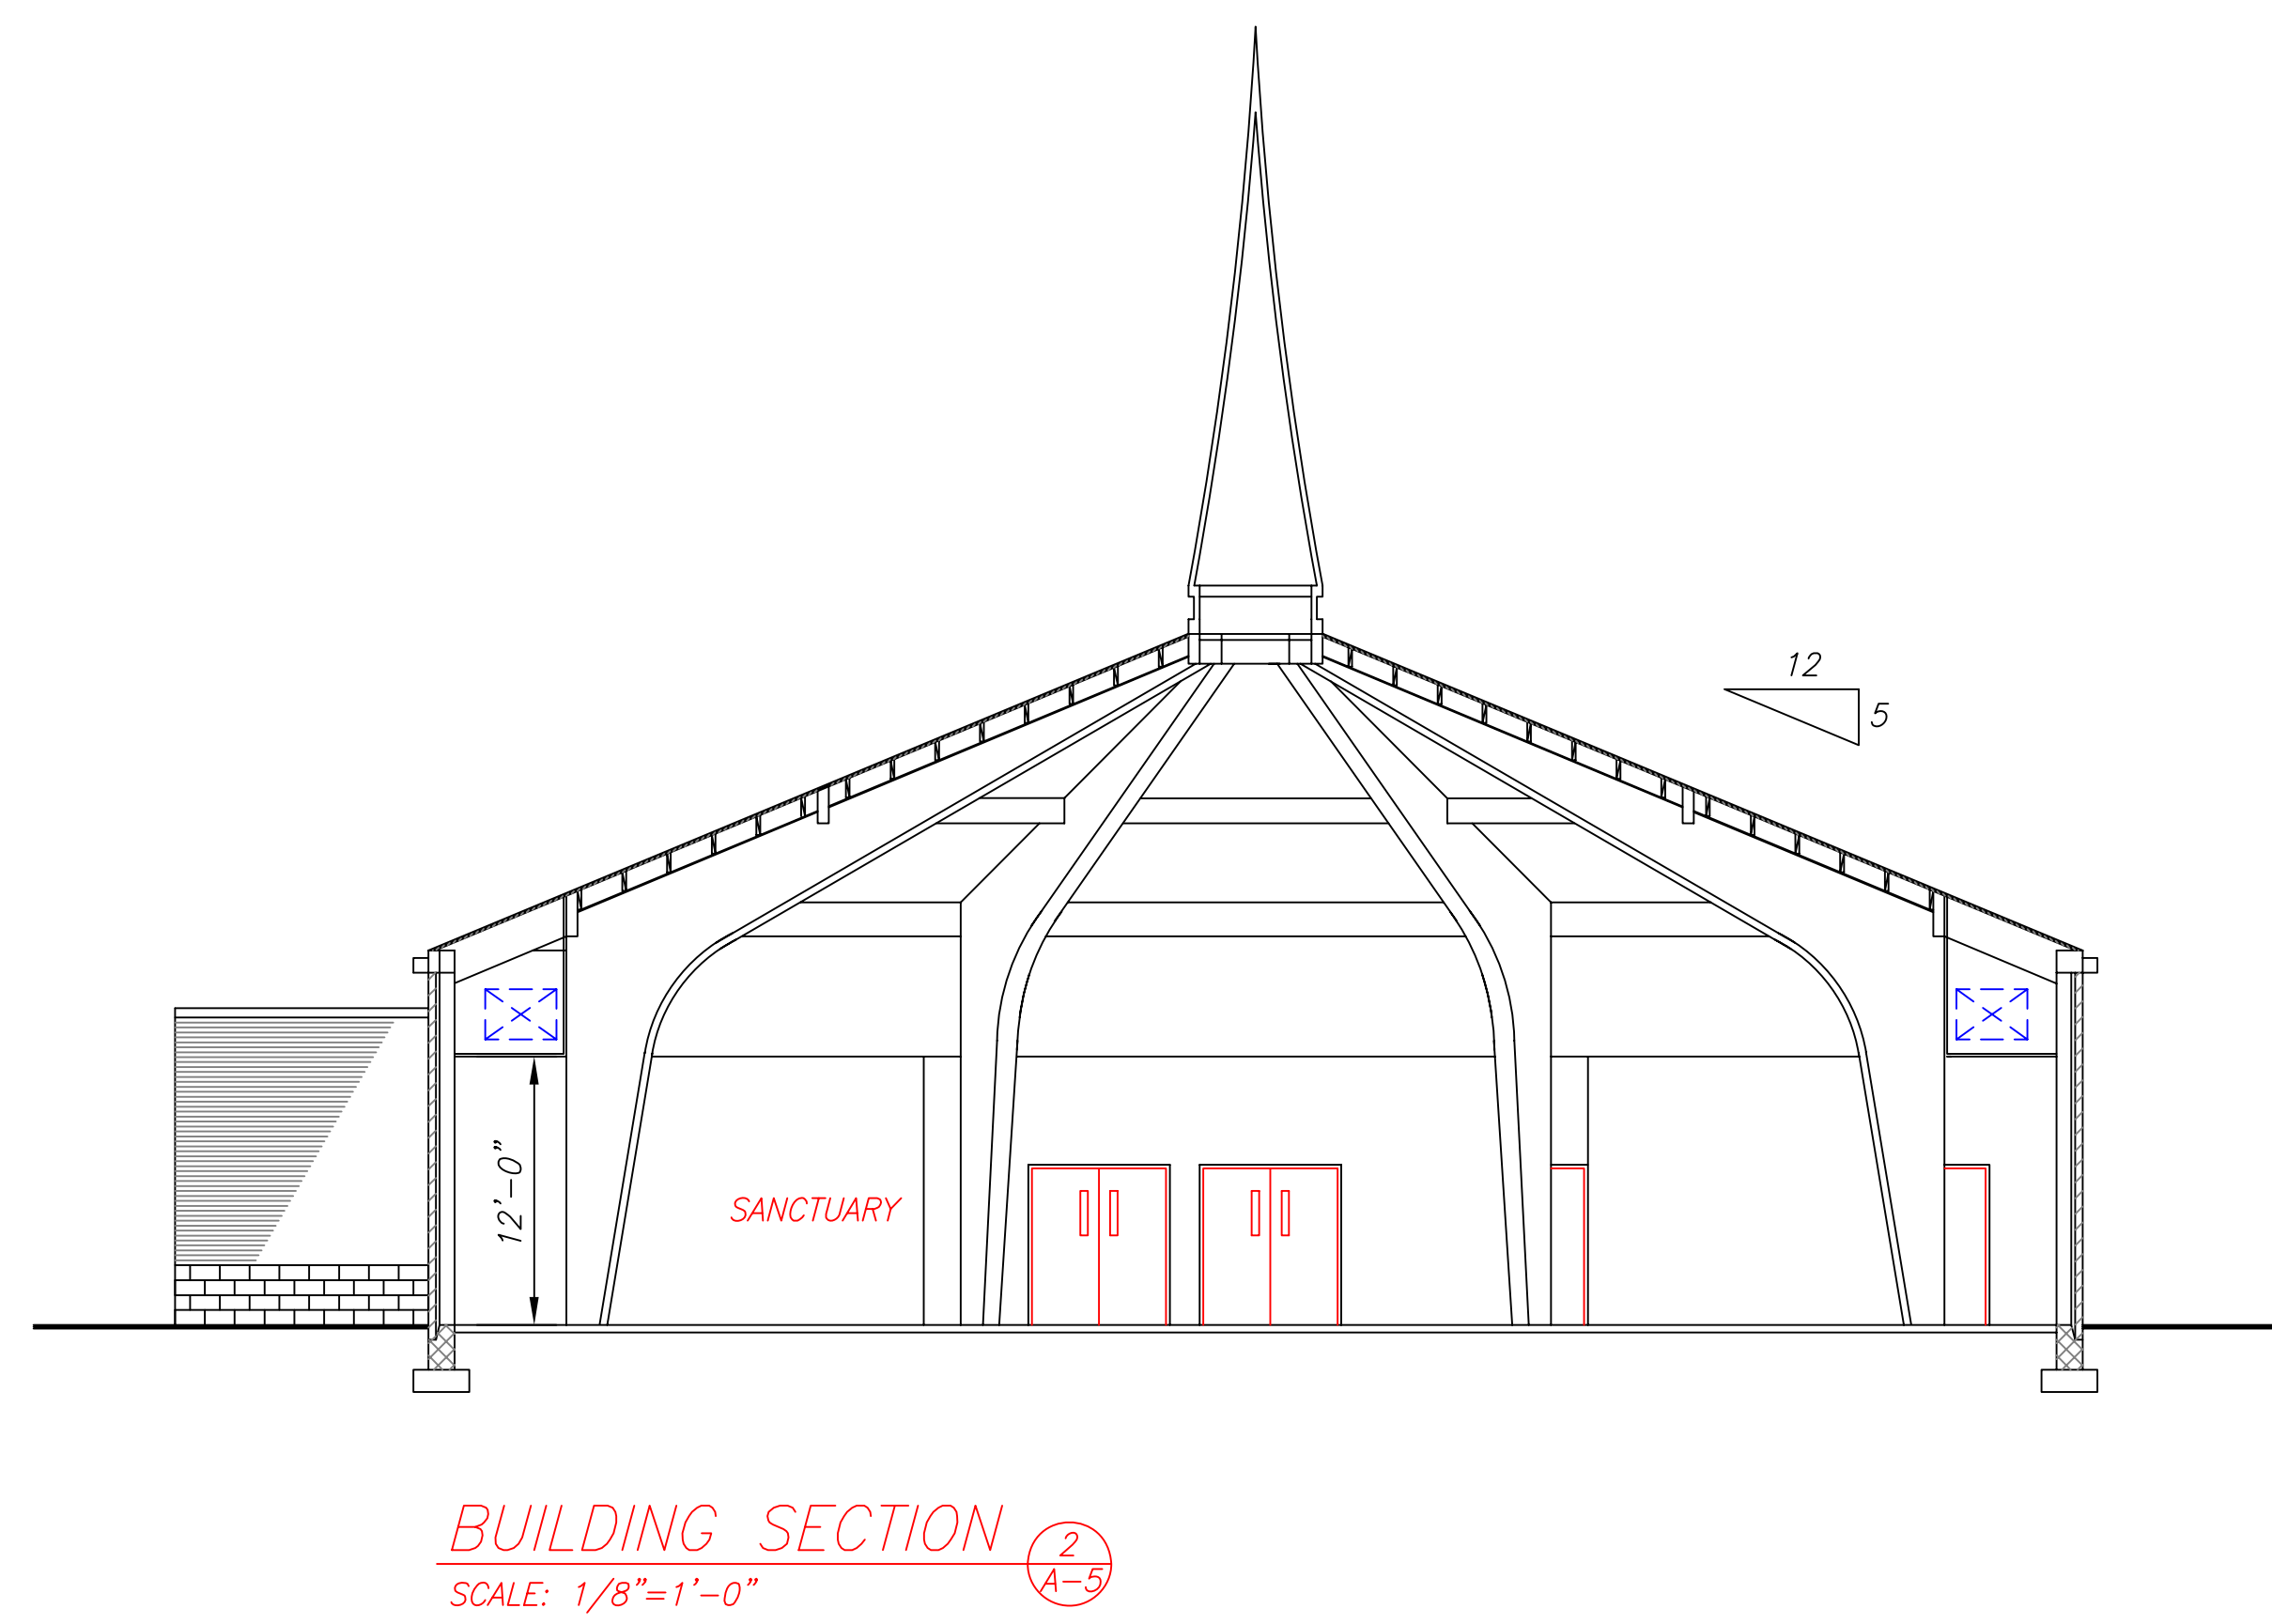


BUILDING SECTION 2
SCALE: 1/8"=1'-0"
A-5

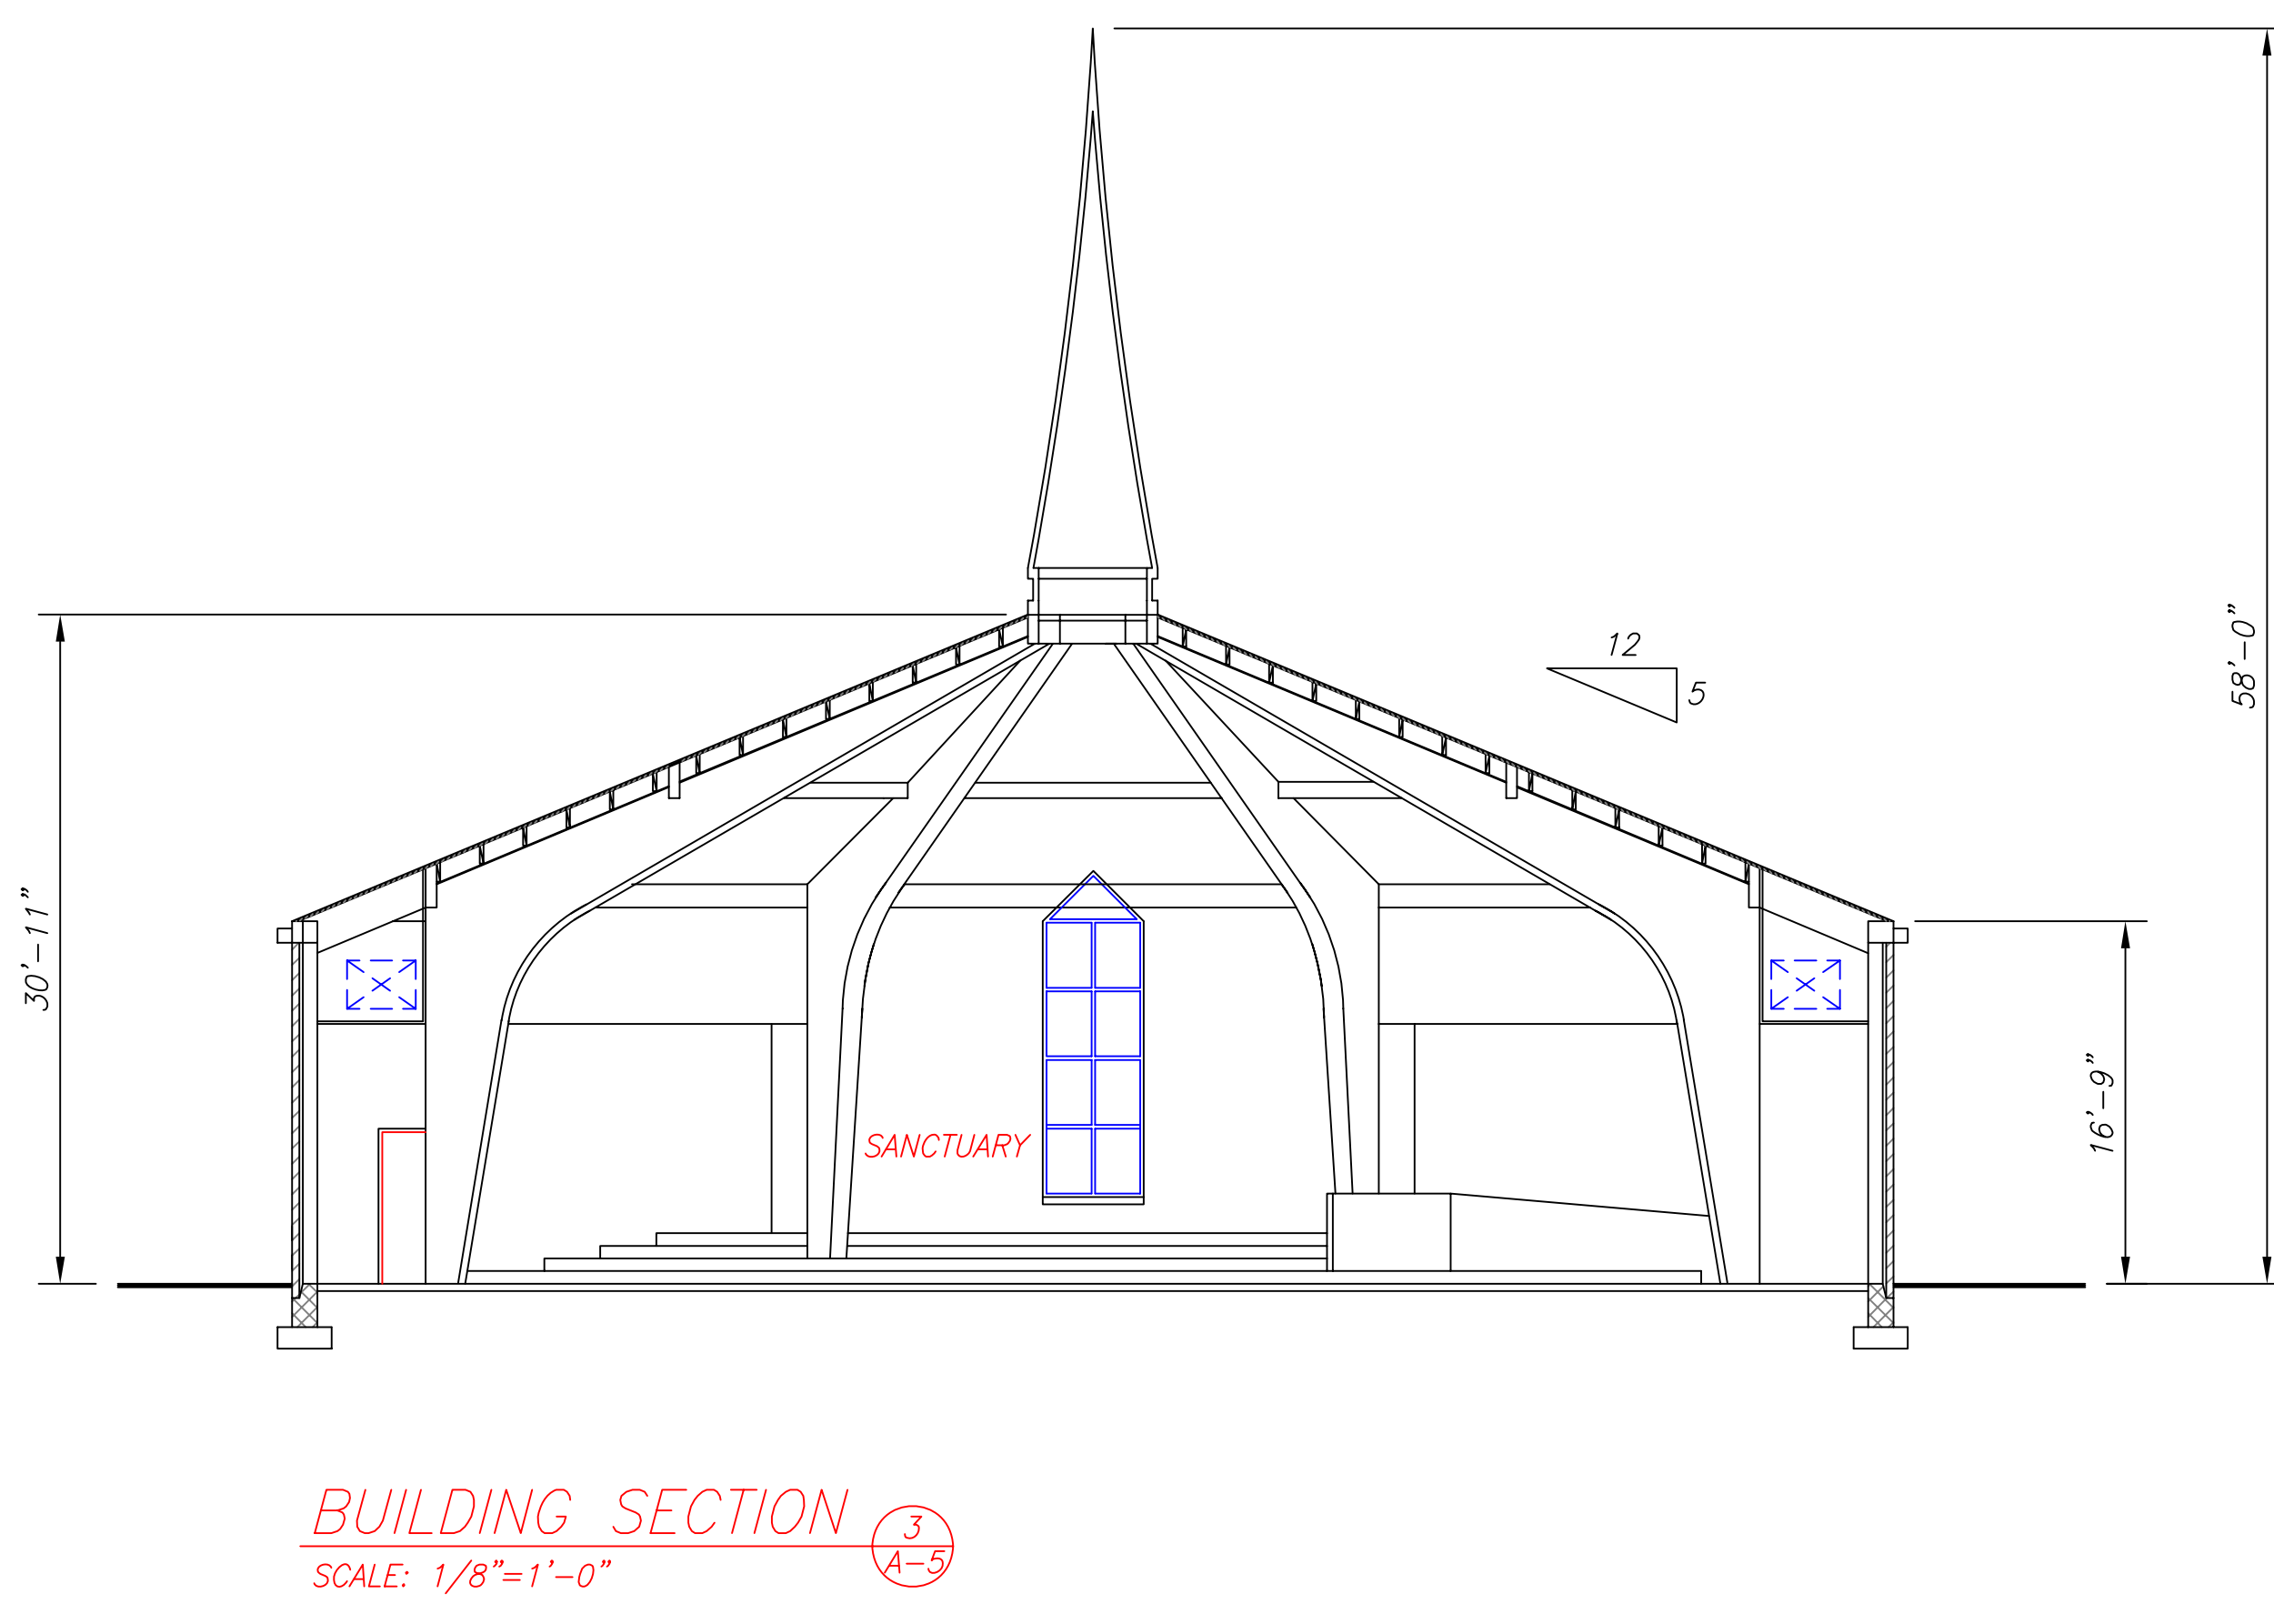


BUILDING SECTION 3
SCALE: 1/8"=1'-0"
A-5

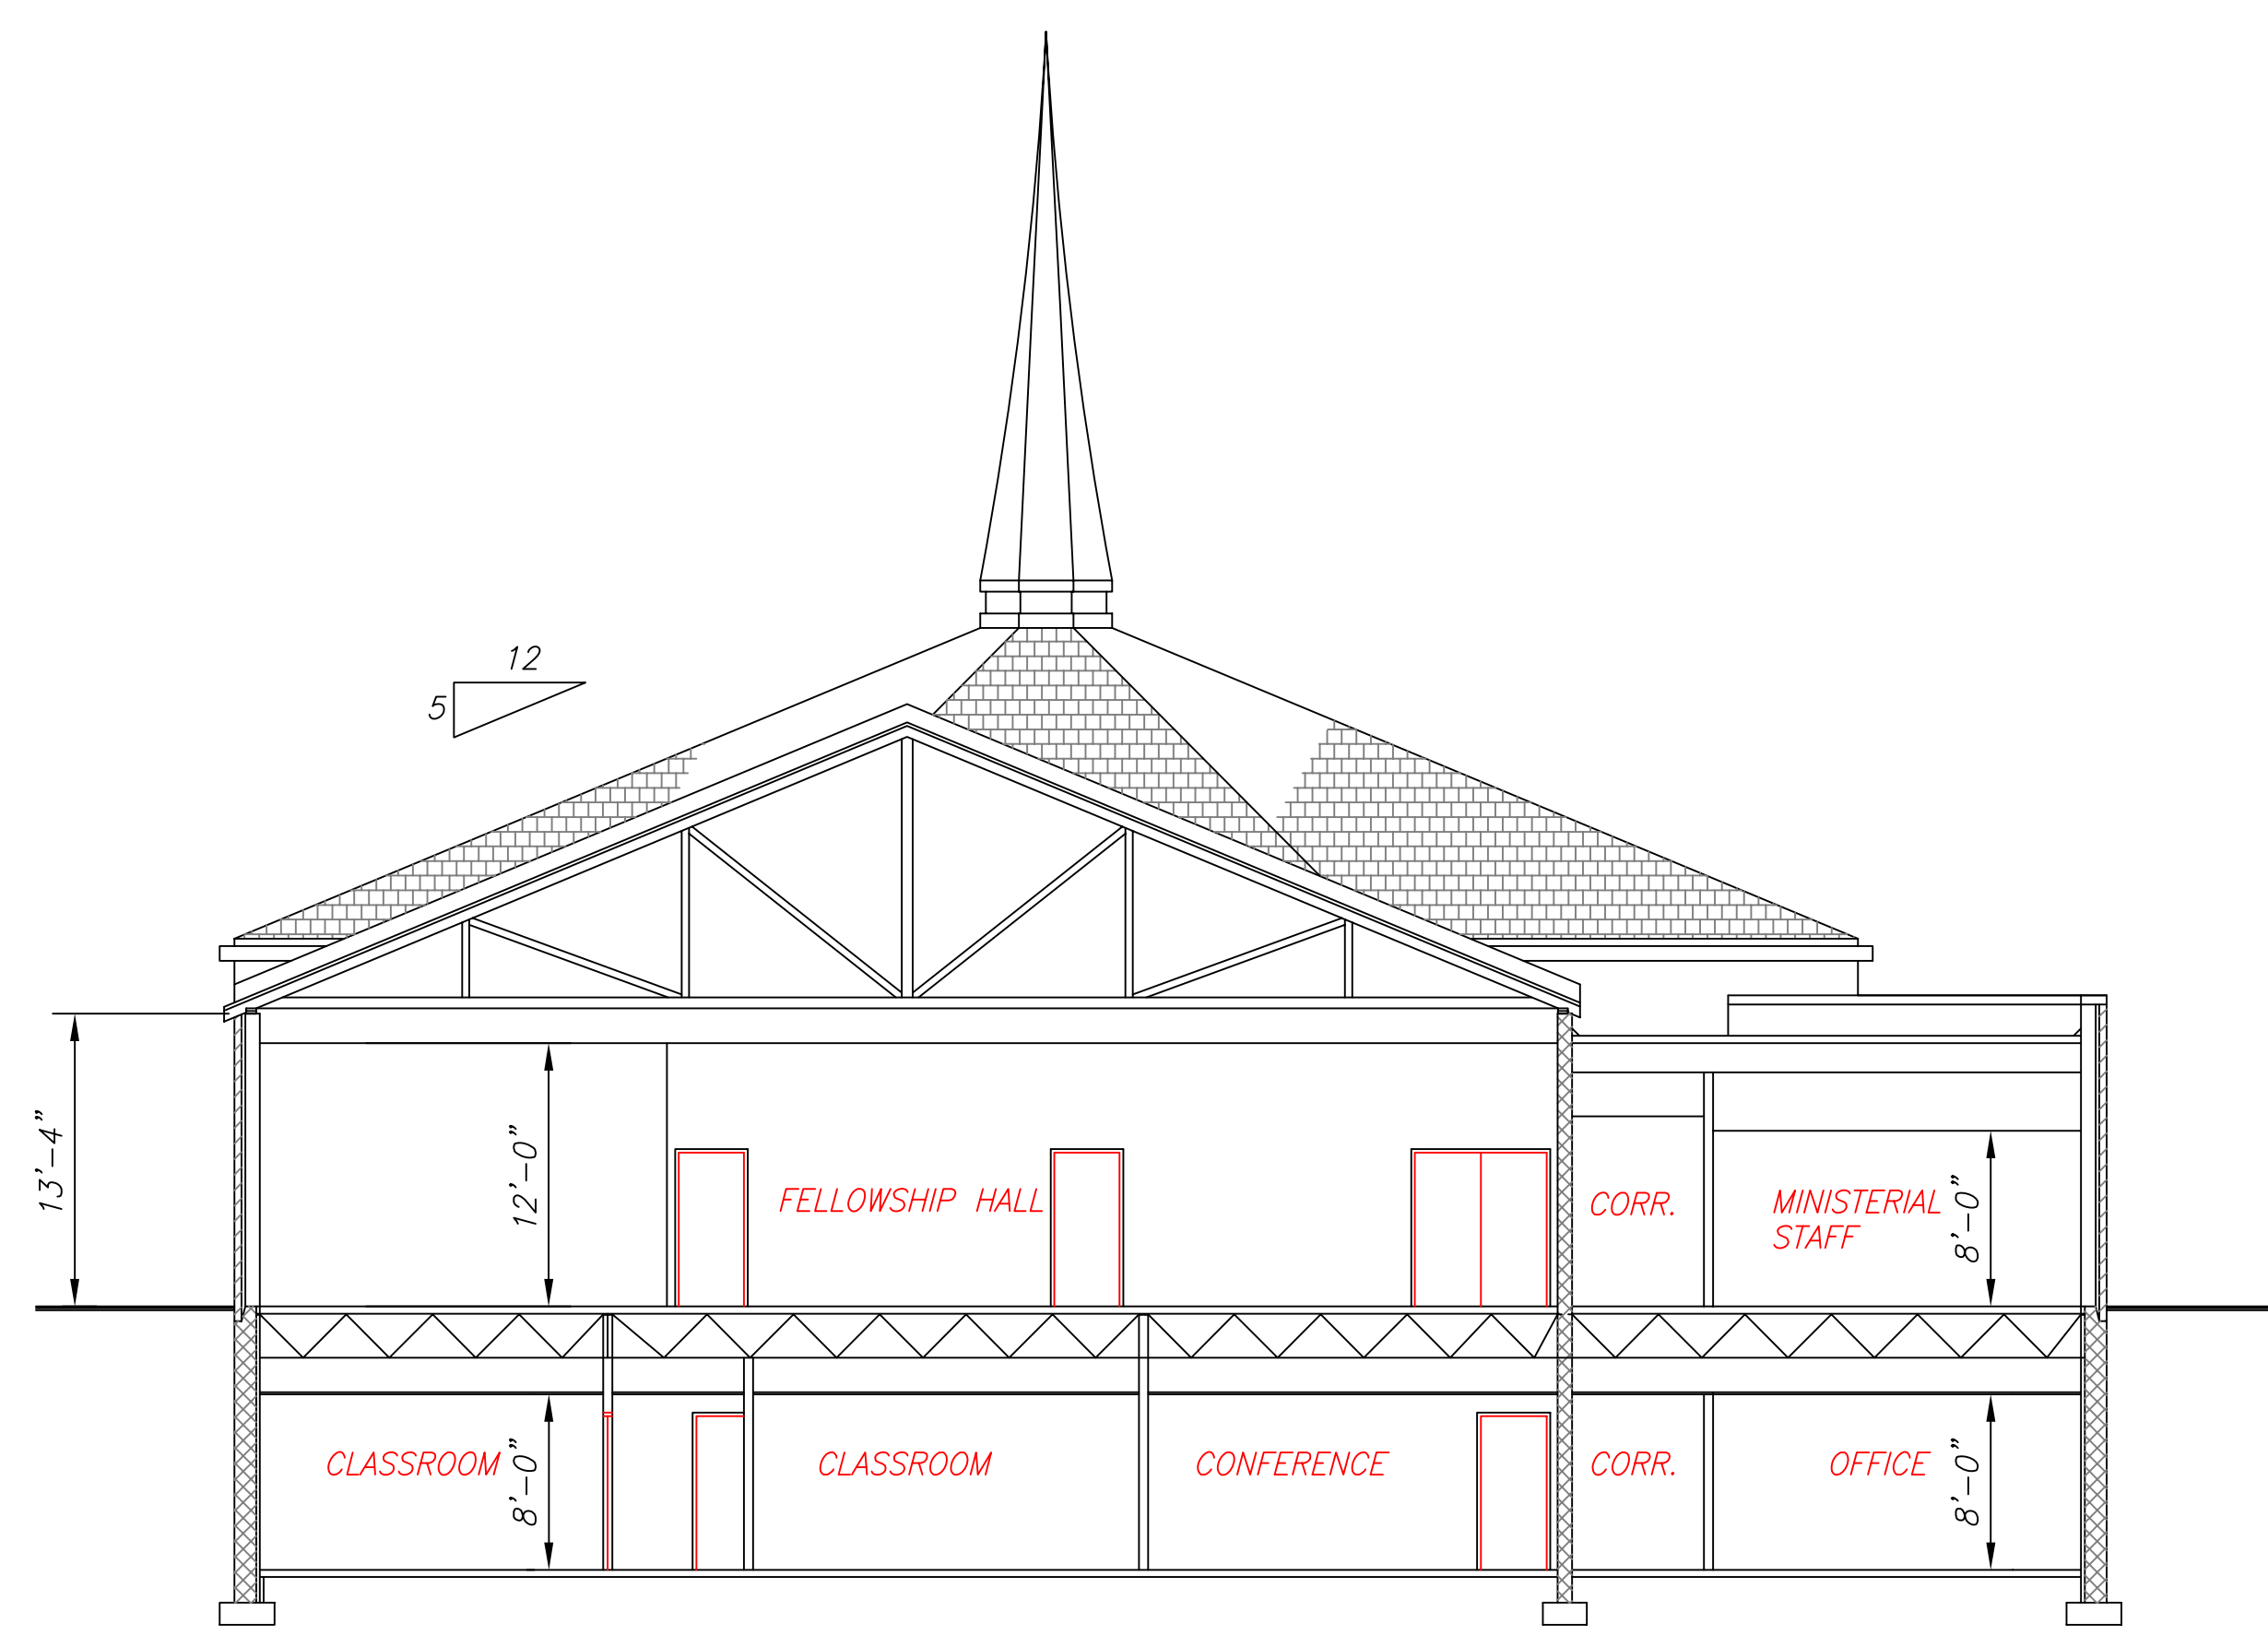

BUILDING SECTION 4
SCALE: 1/8"=1'-0"
A-5

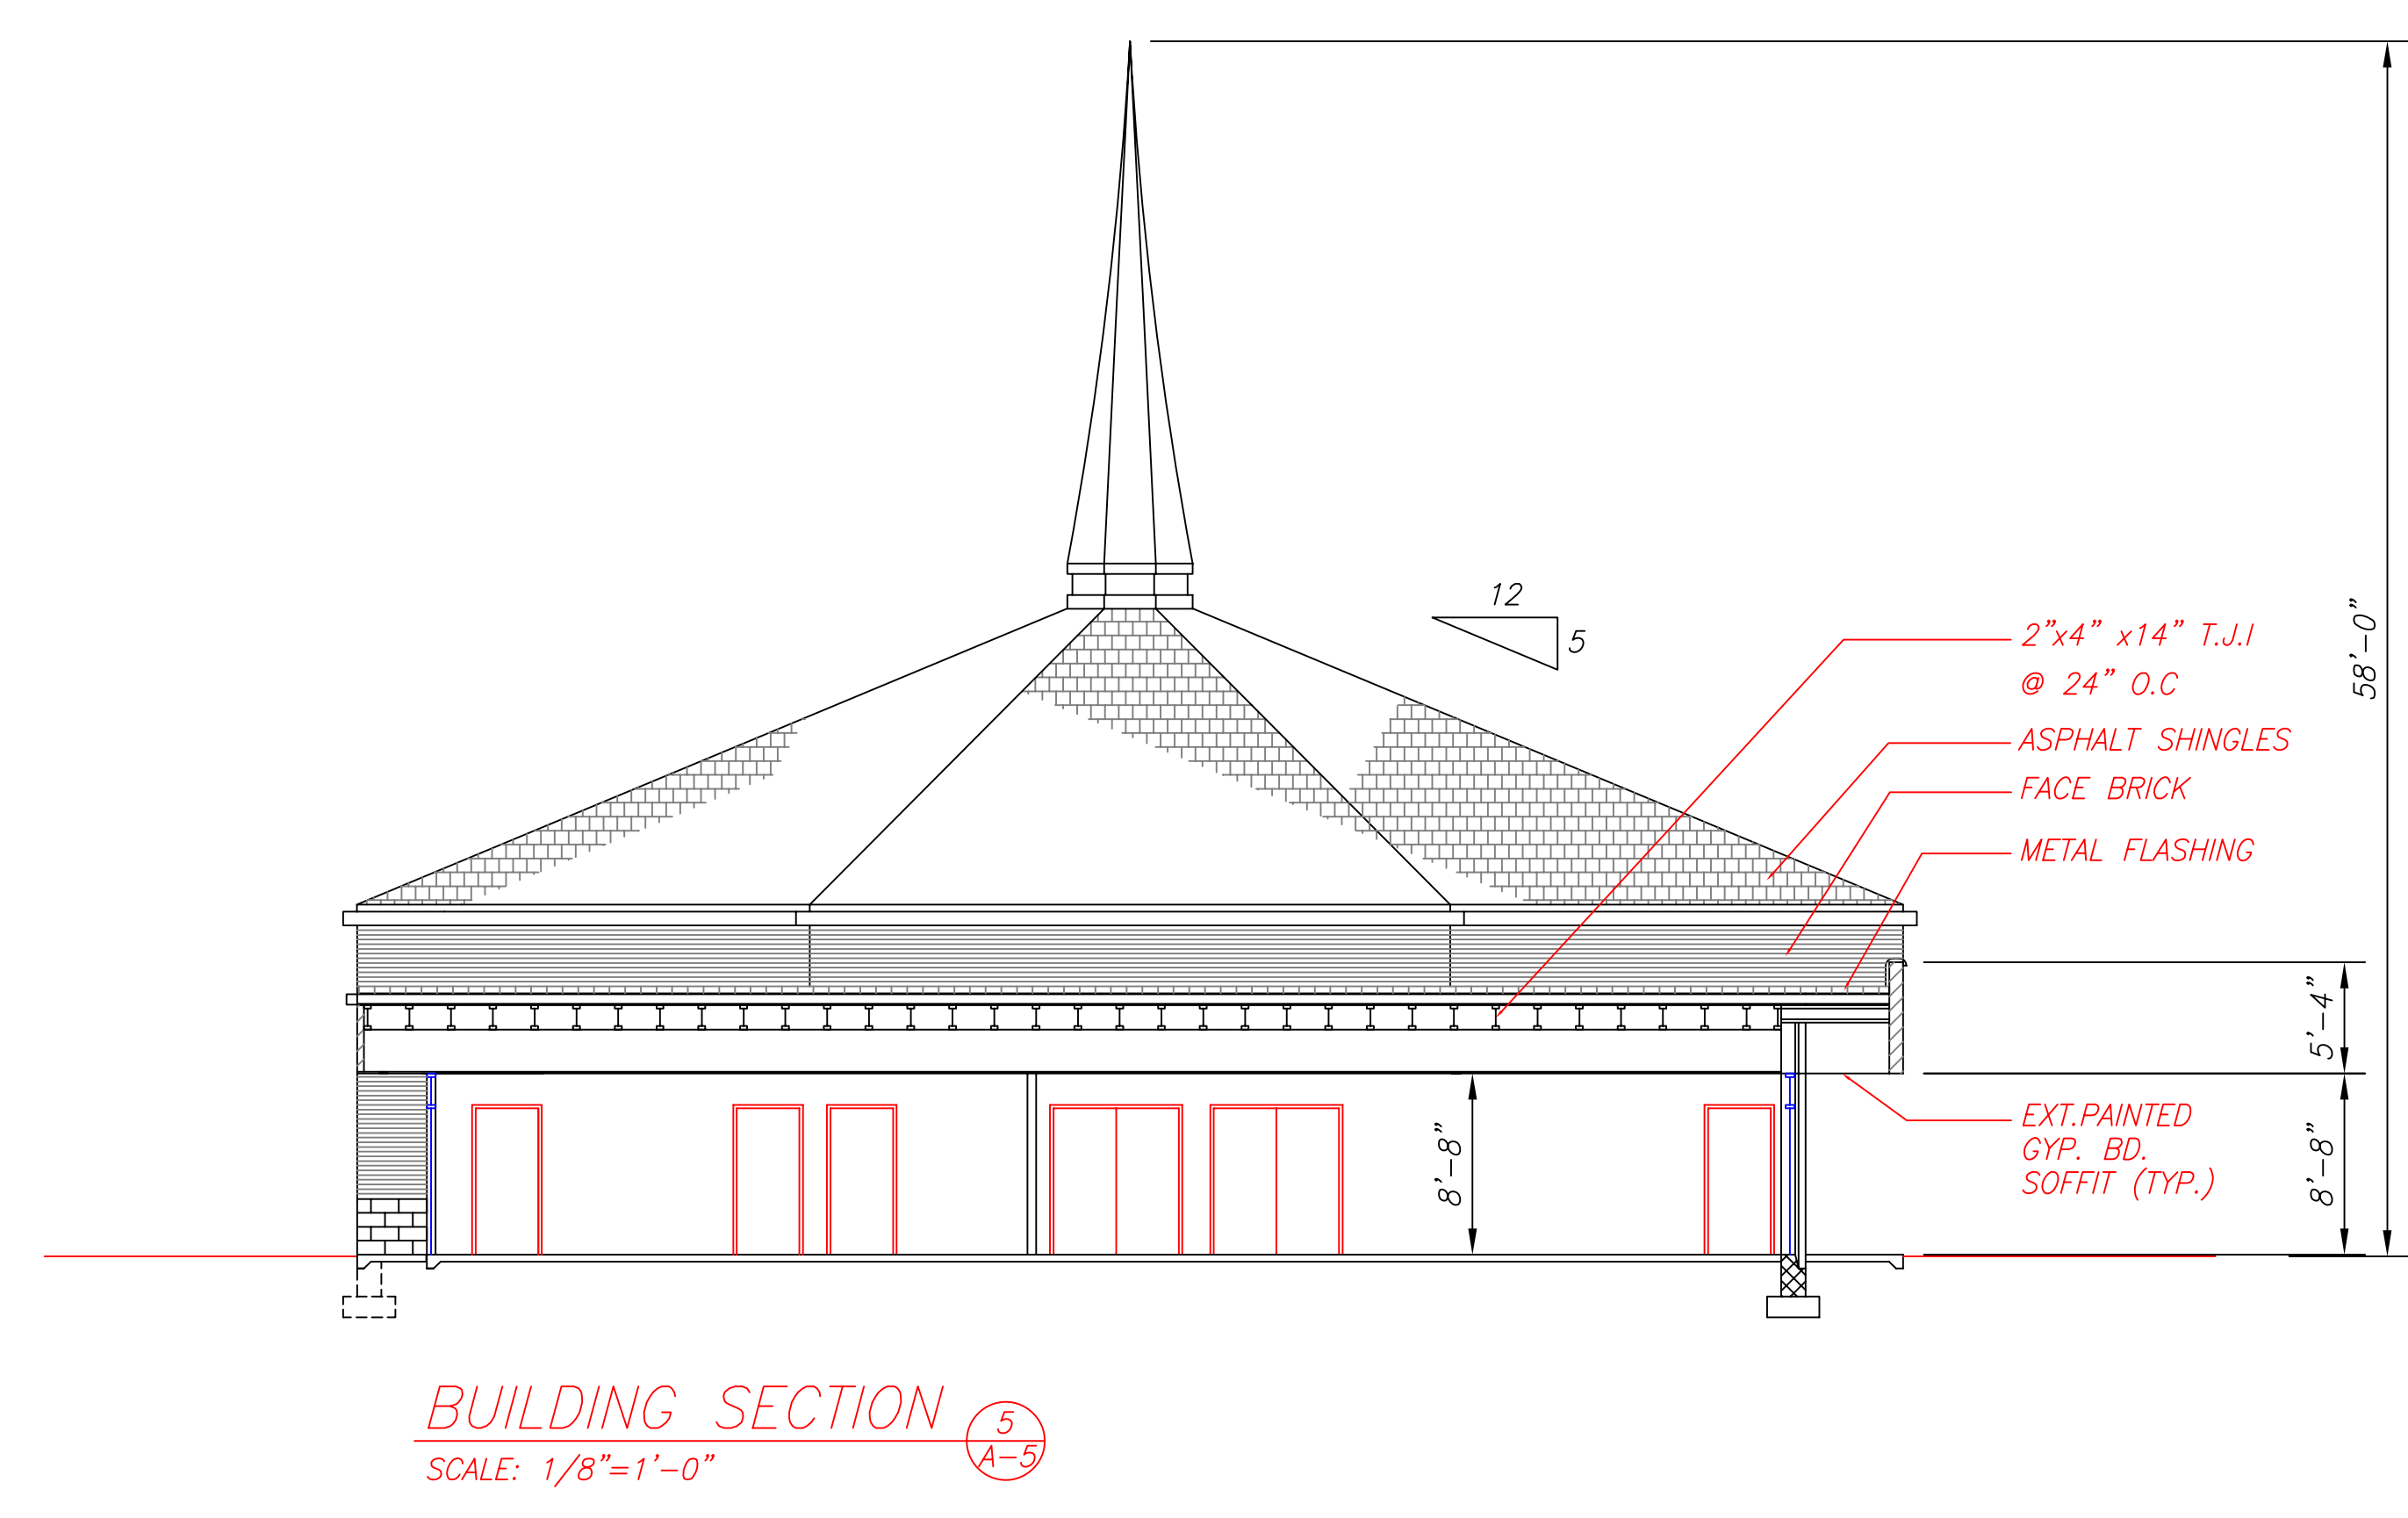

BUILDING SECTION 5
SCALE: 1/8"=1'-0"
A-5

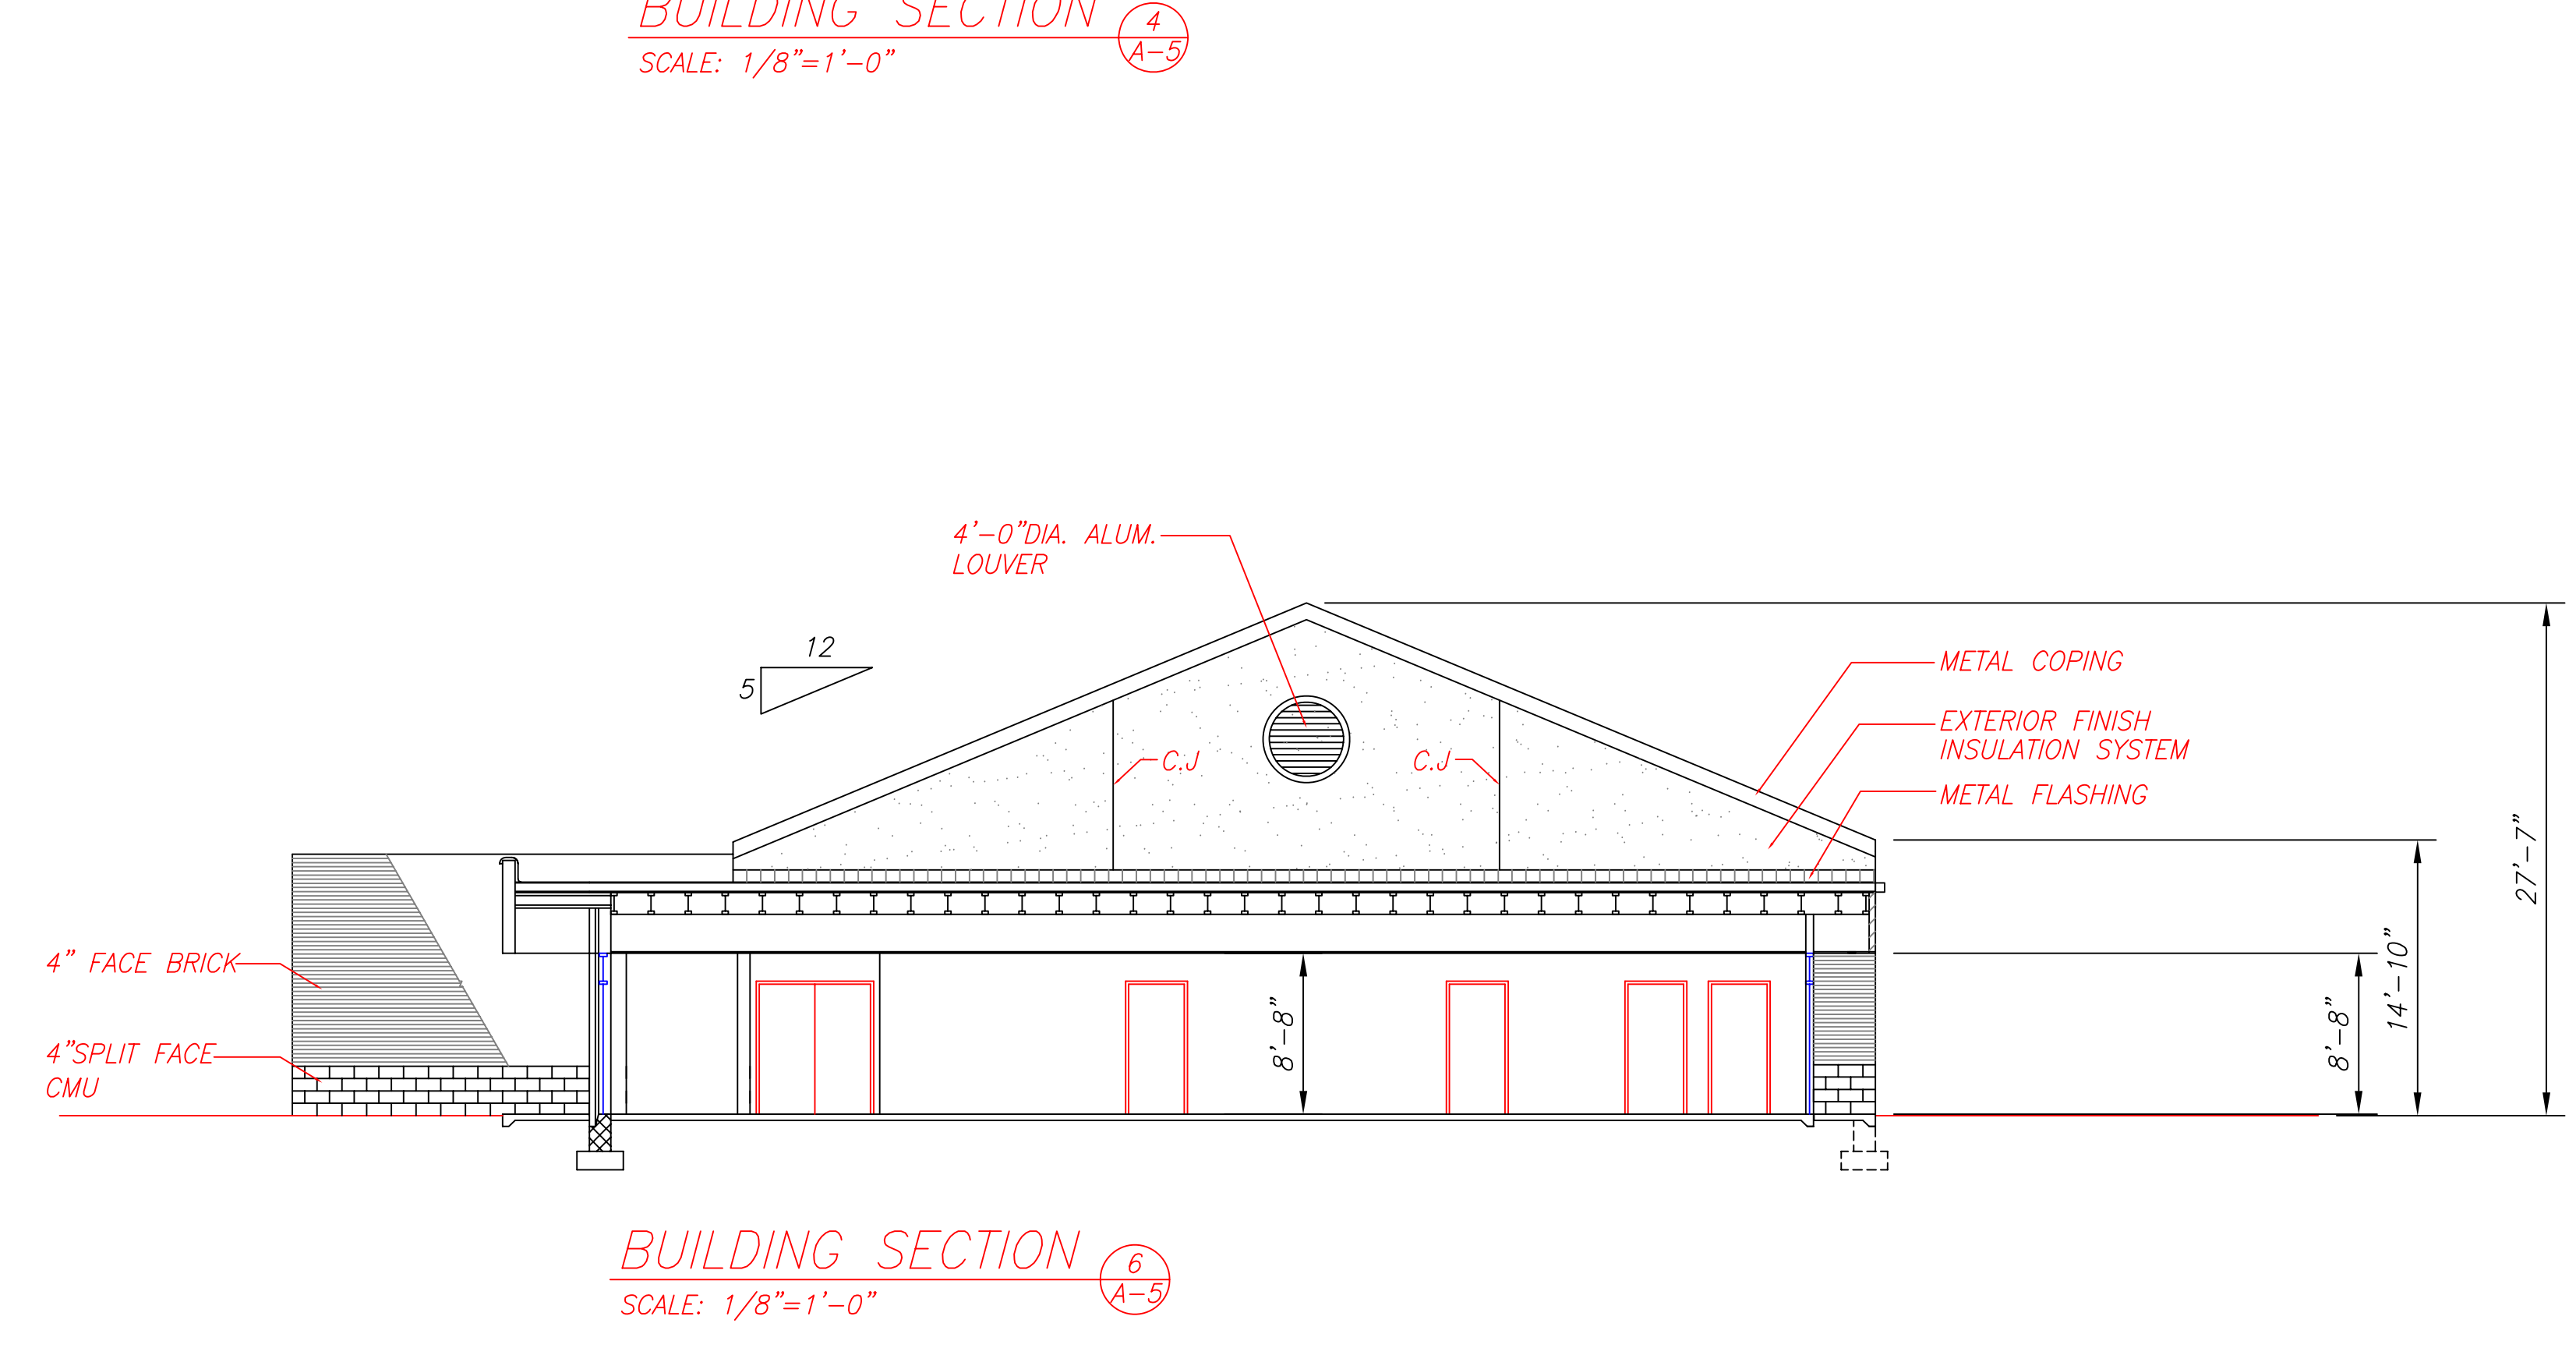

BUILDING SECTION 6
SCALE: 1/8"=1'-0"
A-5

Revisions:

1	COUNTY REVIEW COMMENTS	1-14-08
2	COUNTY REVIEW COMMENTS	5-29-08

Consultants:
WARDER & ASSOCIATES INC.
 CHURCH EXPANSION SPECIALISTS
 8016 Old Alexandria Ferry Road
 Clinton, Maryland 20735
 Phone: 301-868-8900

Certification:

Project Title:
BETH SHALOM A.M.E. ZION CHURCH
 2501 RITCHIE ROAD
 DISTRICT HEIGHTS, MARYLAND 20735
BUILDING SECTIONS

Philip Aaron Lacy, Architects
 6188 Oxon Hill Road, Suite 303
 Oxon Hill, Maryland 20745
 Phone: 301-567-8223

Date: DEC. 1, 2005
 Scale: 1/8"=1'-0"
 Drawn: FCB
 Checked: PAL
 File No. BETH_A05

Drawing No.
A-5
 of