




WALL SECTION 1  
SCALE: 3/4"=1'-0" (A-6)

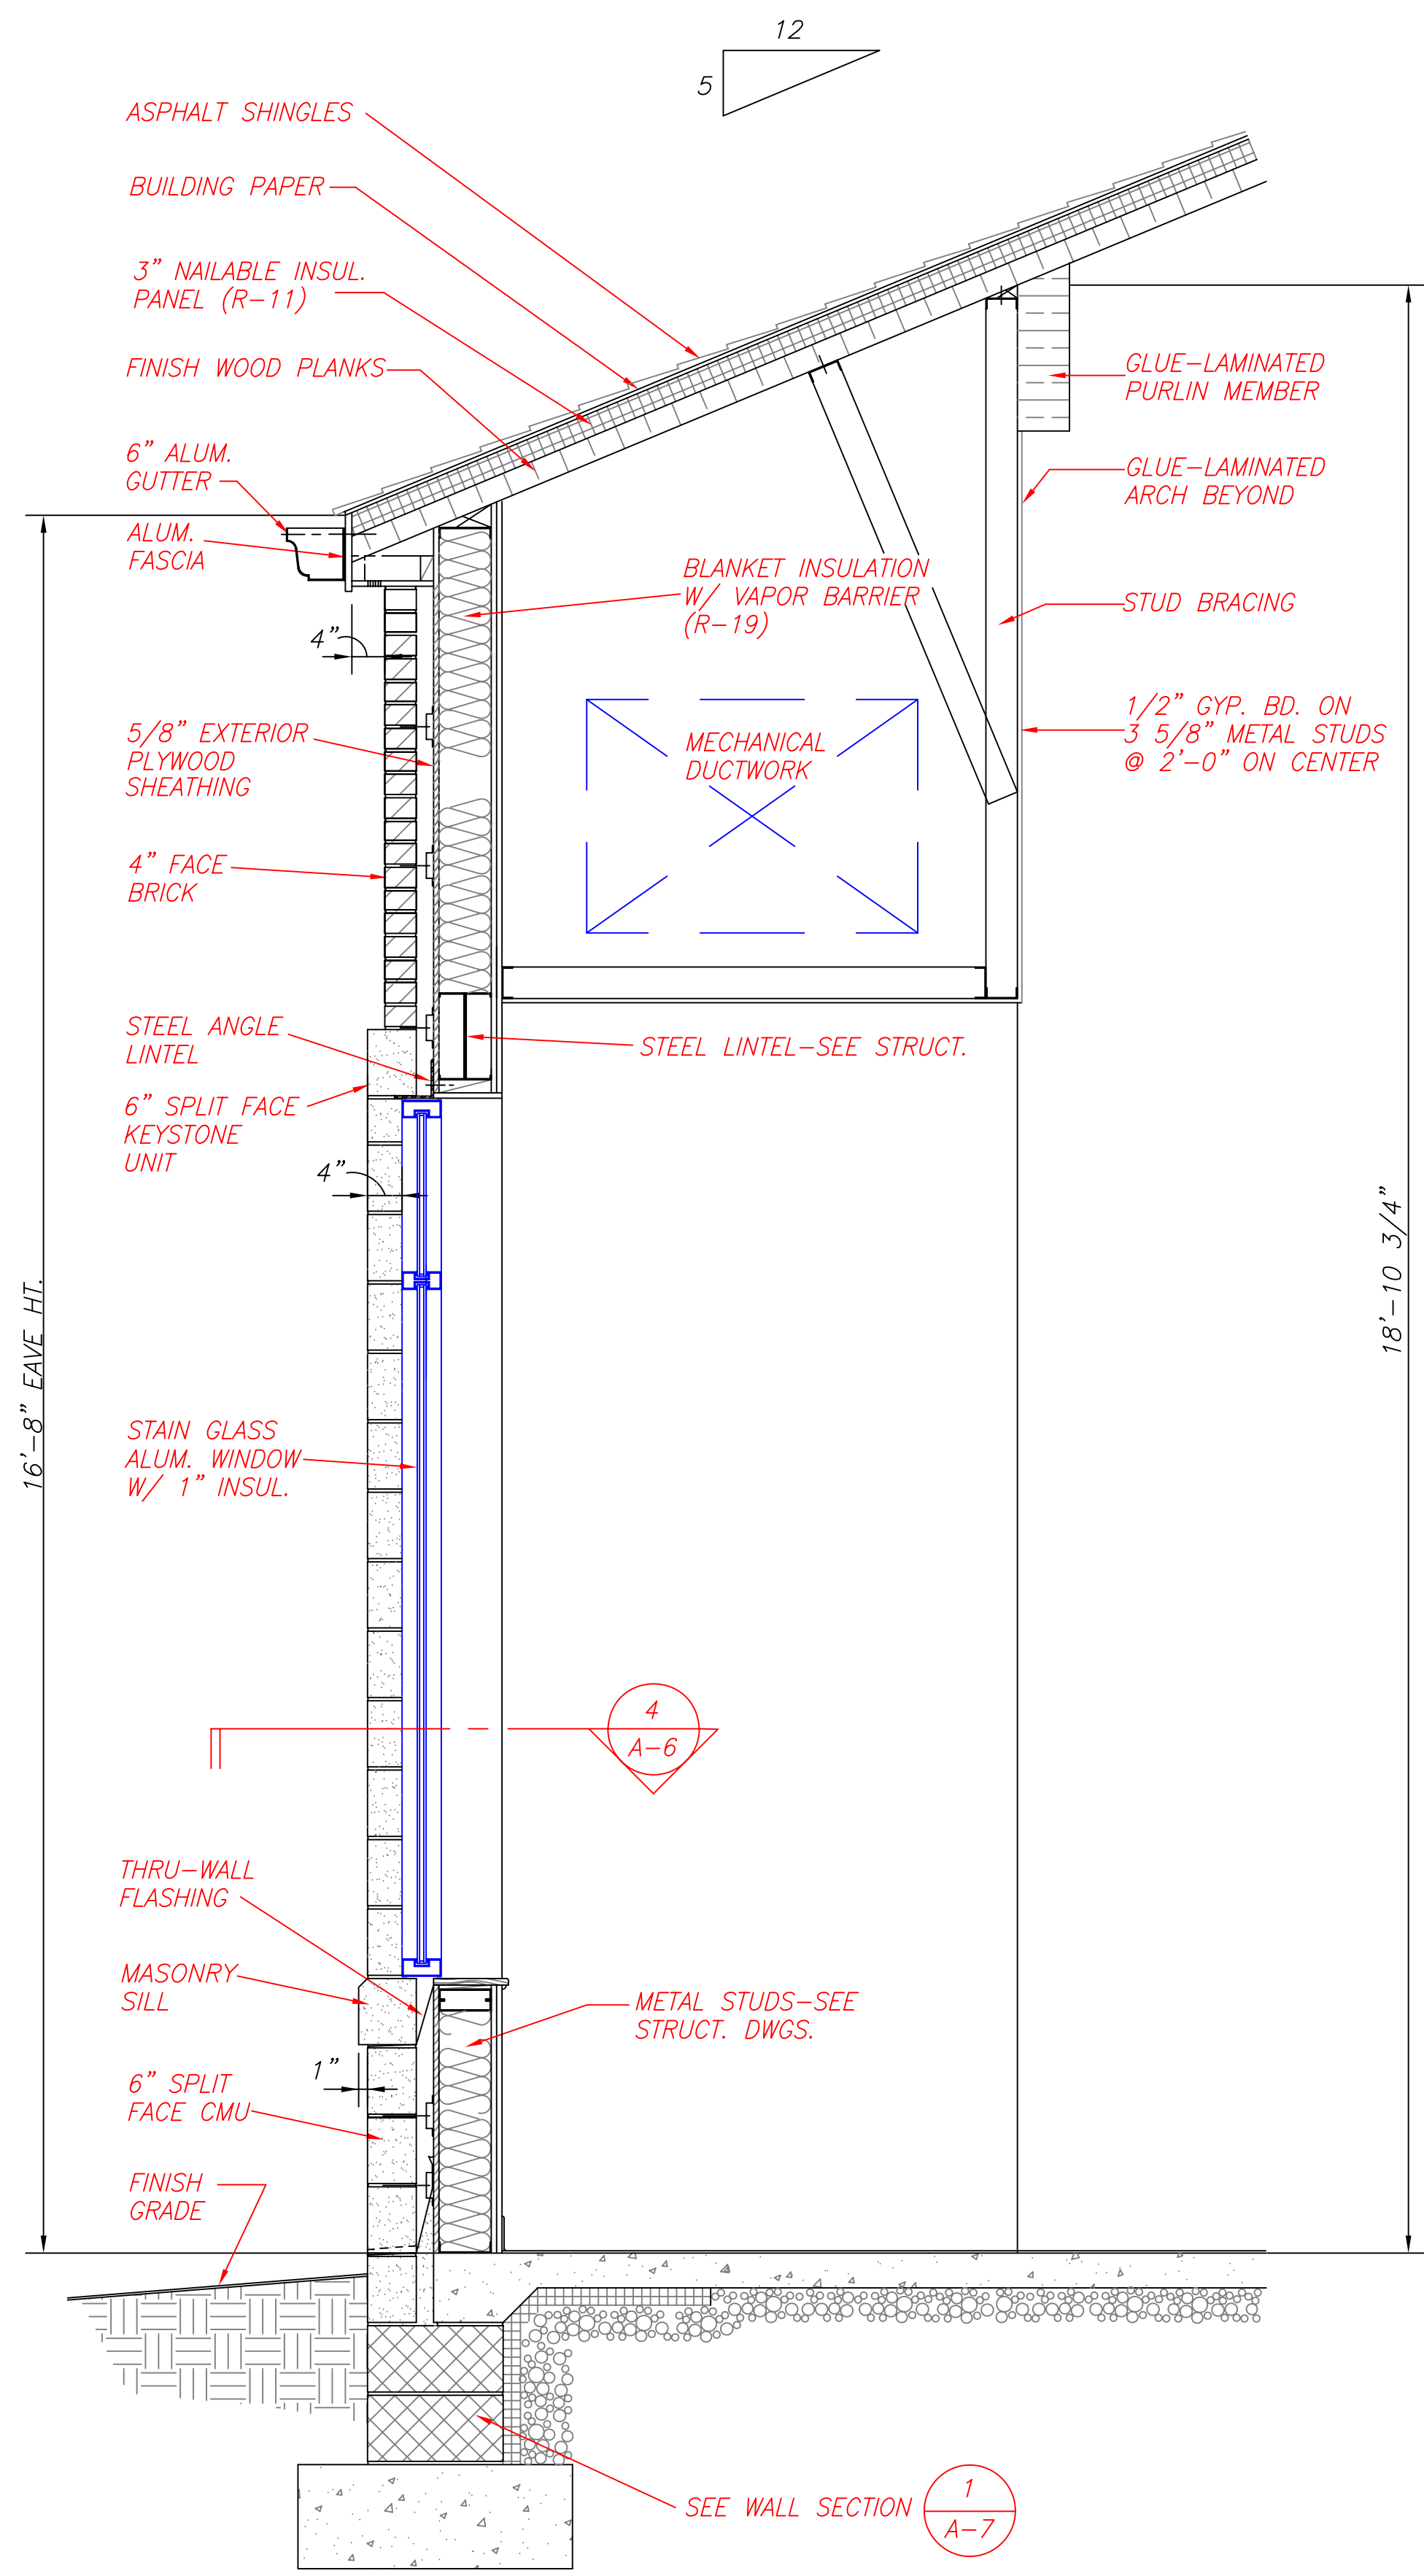

WALL SECTION 2  
SCALE: 3/4"=1'-0" (A-6)

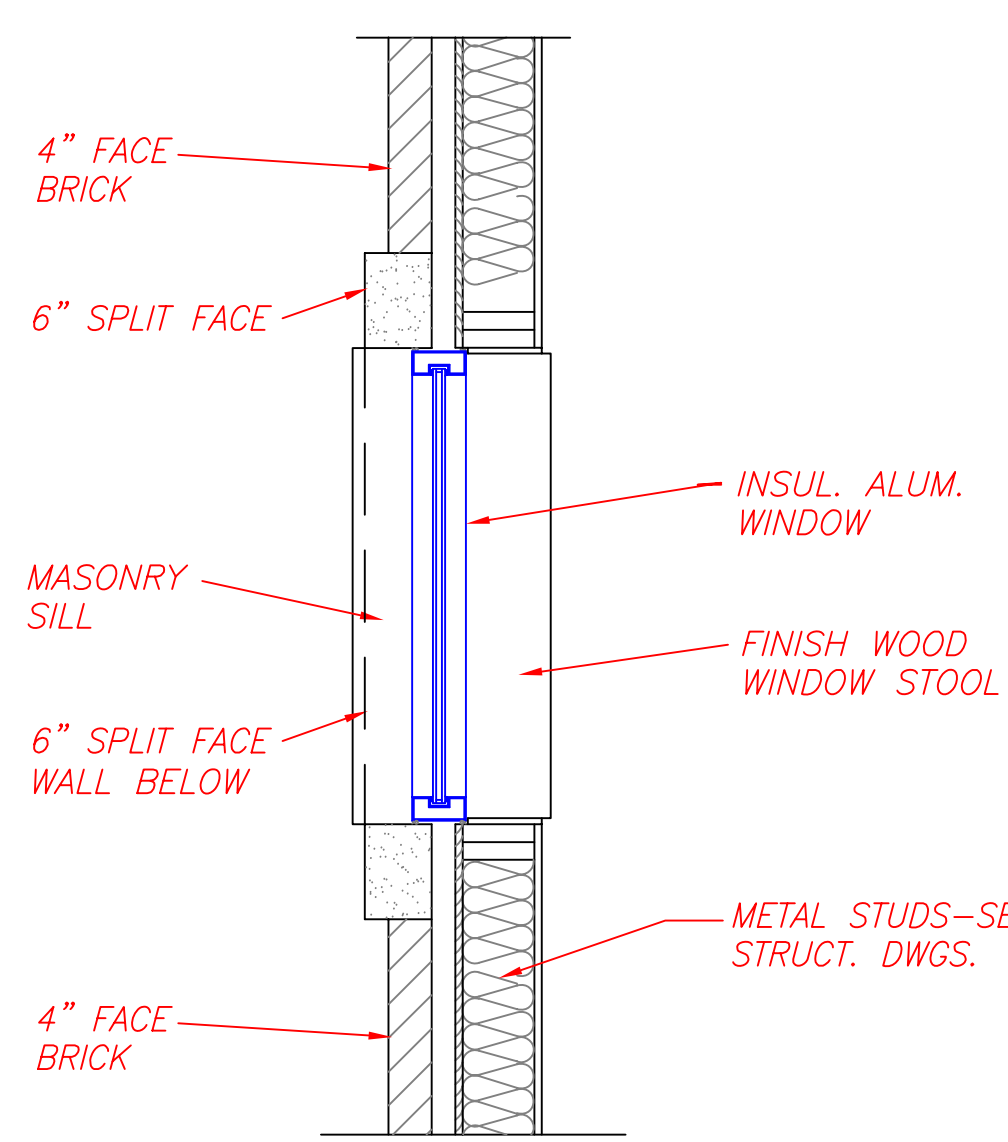

PLAN SECTION 4  
SCALE: 3/4"=1'-0" (A-6)

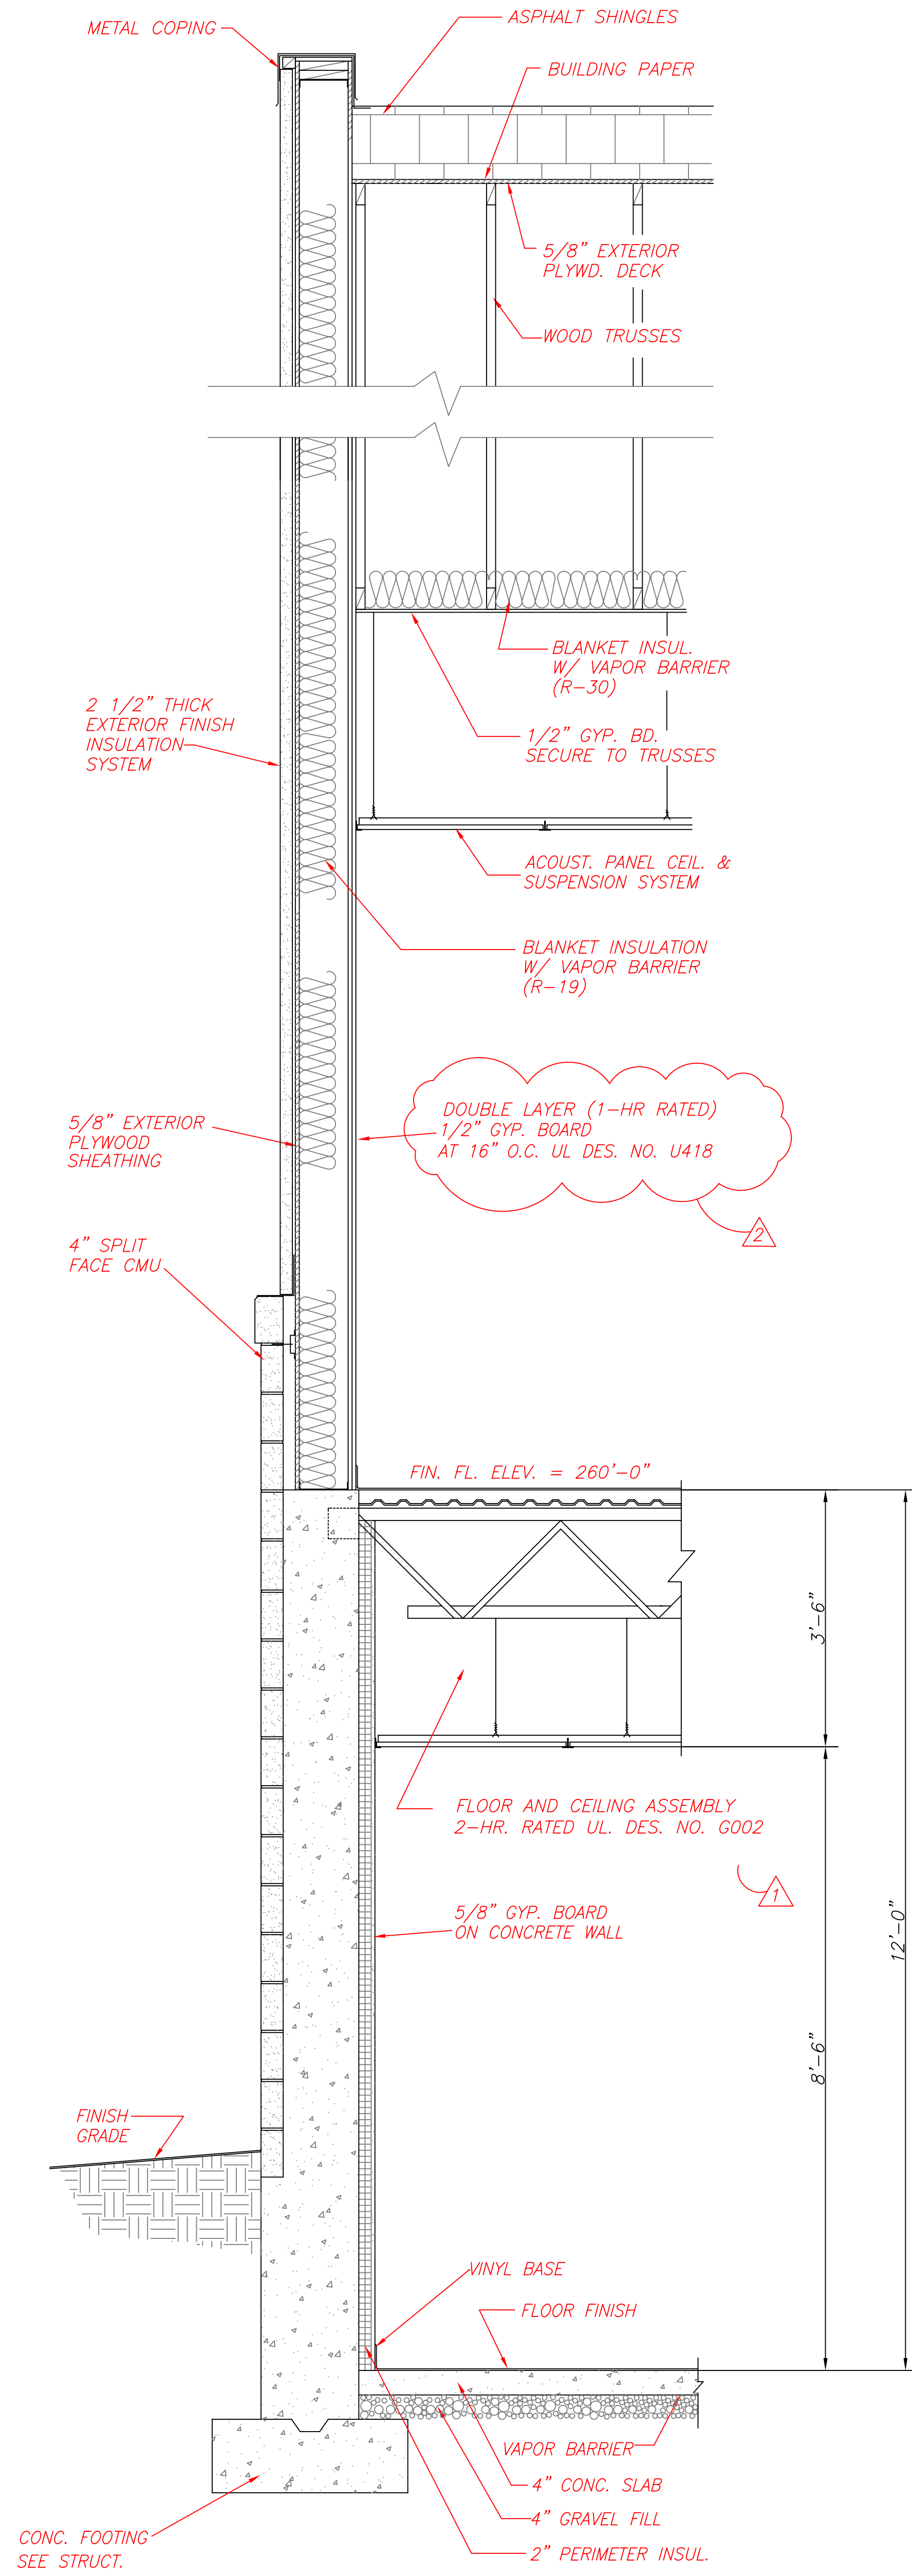

WALL SECTION 3  
SCALE: 3/4"=1'-0" (A-6)

Date:	1-14-08
Revisions:	1 COUNTY REVIEW COMMENTS
	2 COUNTY REVIEW COMMENTS

Consultants:  
WARDER & ASSOCIATES, INC.  
CHURCH EXPANSION SPECIALIST  
8016 CLINTON MARLBORO ROAD  
CLINTON, MARYLAND 20734  
PHONE: 301-868-5900

Certification:

Project Title:  
BETH SHALOM A.M.E. ZION CHURCH  
2501 RITCHIE ROAD  
DISTRICT HEIGHTS, MARYLAND 20735  
WALL SECTIONS

Philip Aaron Lacy, Architects  
6188 Oxon Hill Road, Suite 303  
Oxon Hill, Maryland 20745  
Phone: 301-567-8223

Date: DEC. 1, 2005  
Scale: 3/4"=1'-0"  
Drawn: FCB  
Checked: PAL  
File No. BETH\_A06

Drawing No.  
A-6  
of